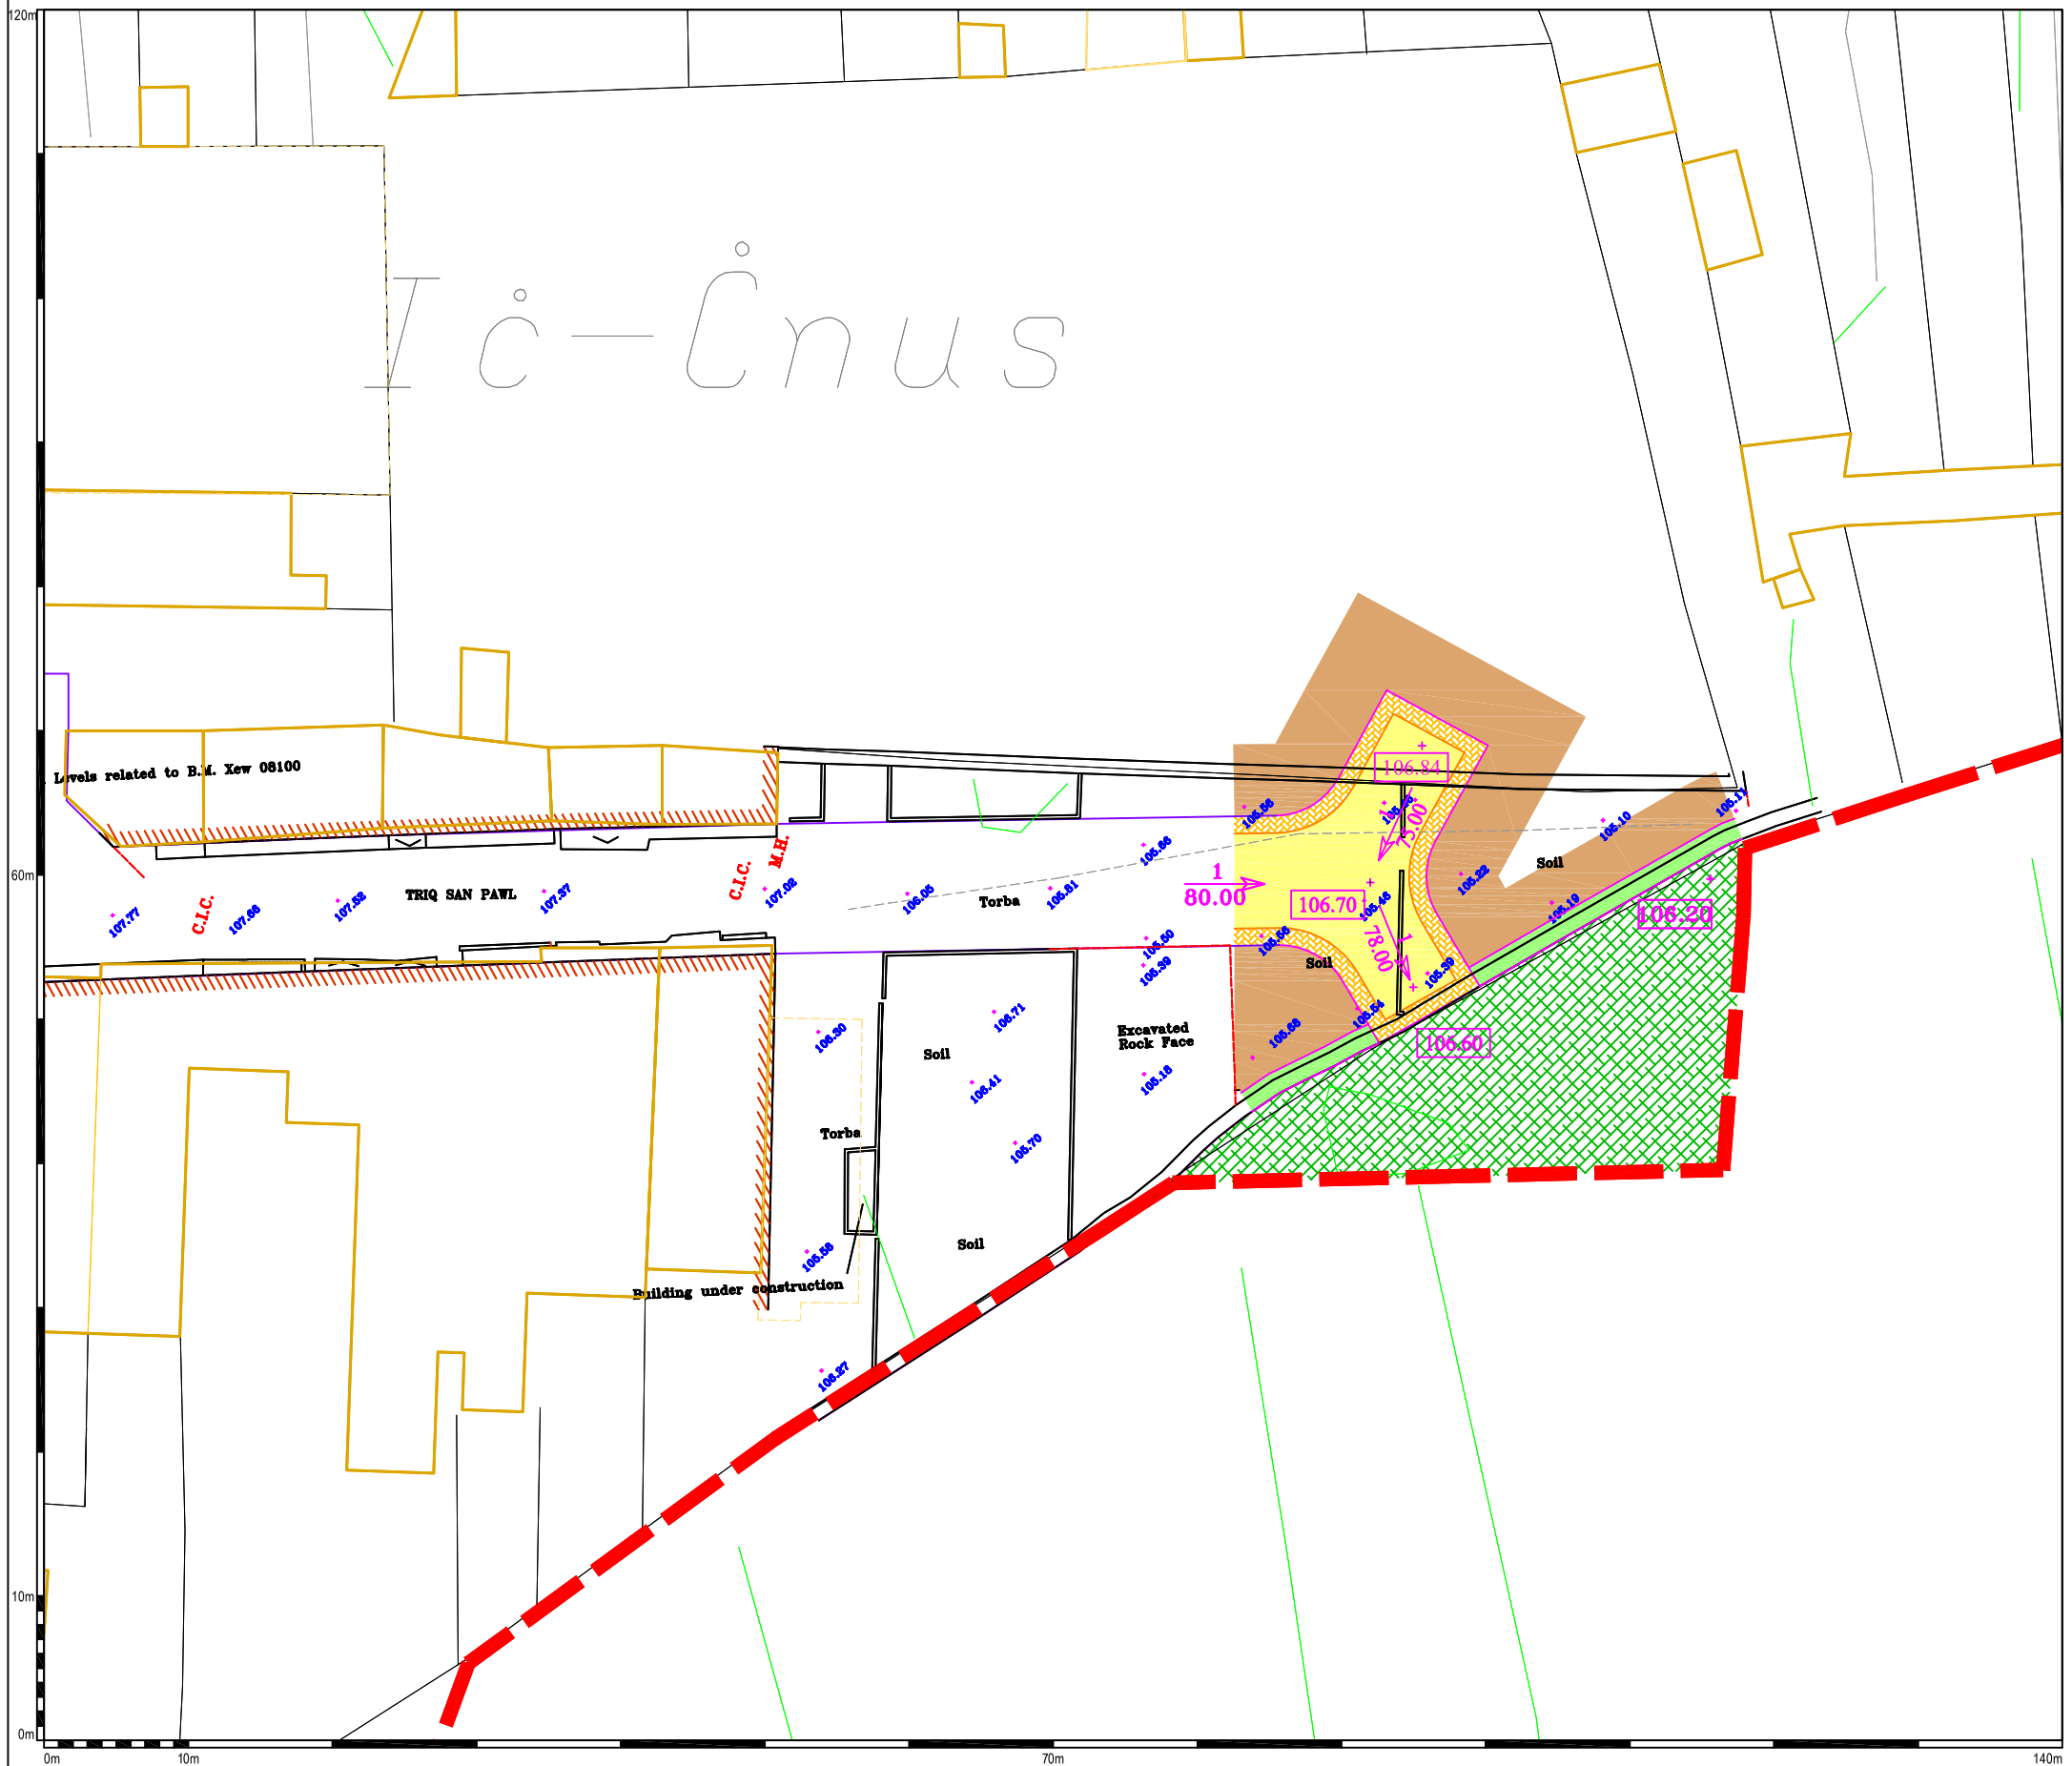

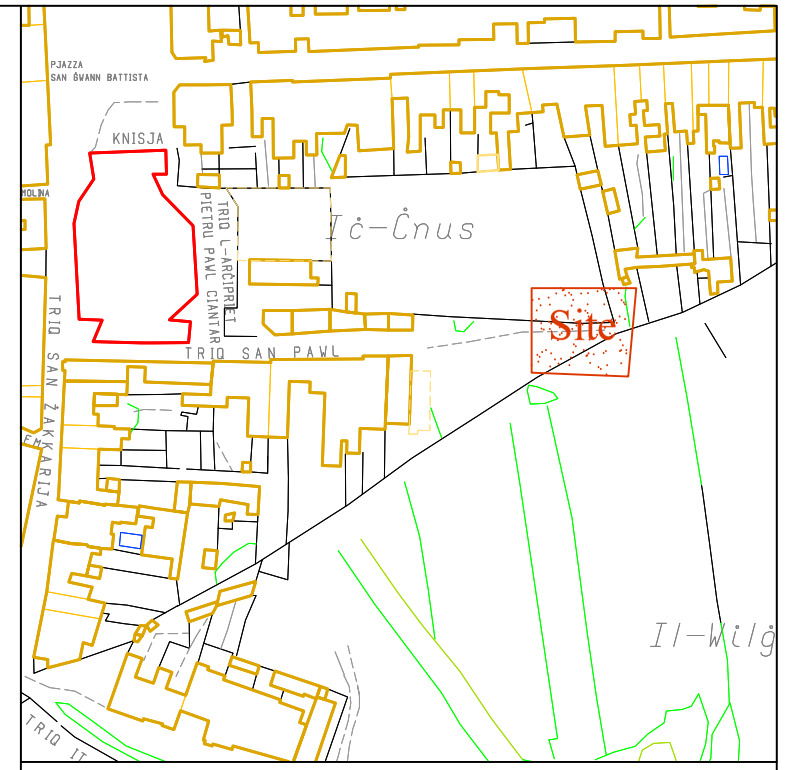

S.S. No.: 03287 Scale: 1:2500

PLANNING AUTHORITY

Subsidiary Plan
Minor Modification

Locality:

Xewkija

Plan Reference Number:

Partial Local Plan Review

Scale: 1:500	Survey No.: XWK 1276e1-16
Grid System: U.T.M. Scale Factor: 0.999632	Min. Coordinates: 33520|87820 Level datum: M.S.L.
Survey Completion Date: 22/12/2016	Plan Completion Date: 20/01/2017
Survey Checked By: M. Azzopardi (LSU)	Plan Checked By: L. Stafrace

Remarks:

Map 3

Disclaimer:

The information on this plan has been carefully checked for accuracy at the time of survey. However the Planning Authority cannot assume responsibility for any changes occuring after the date of the survey and cannot be held liable for damages resulting from interpretation or misuse of the information on this plan.

Legend:

- Existing Field Walls
- Existing Building
- Existing Vegetation
- E.P.O Street Furniture
- Limit to Development
- +46.29 Spot Level
- +20.00 Formation Level
- Front/Side Garden
- Scheme Road
- Green Area
- Pedestrian Area
- Terraced Development (Residential) GCLP Policy GZ-EDGE-1
- Alignment
- Proposed Alignment

Water reservoirs to be of a volume of 20% larger than the minimum requirement of L.N. 227 of 2016, Development Planning (Health and Sanitary) Regulations, 2016.